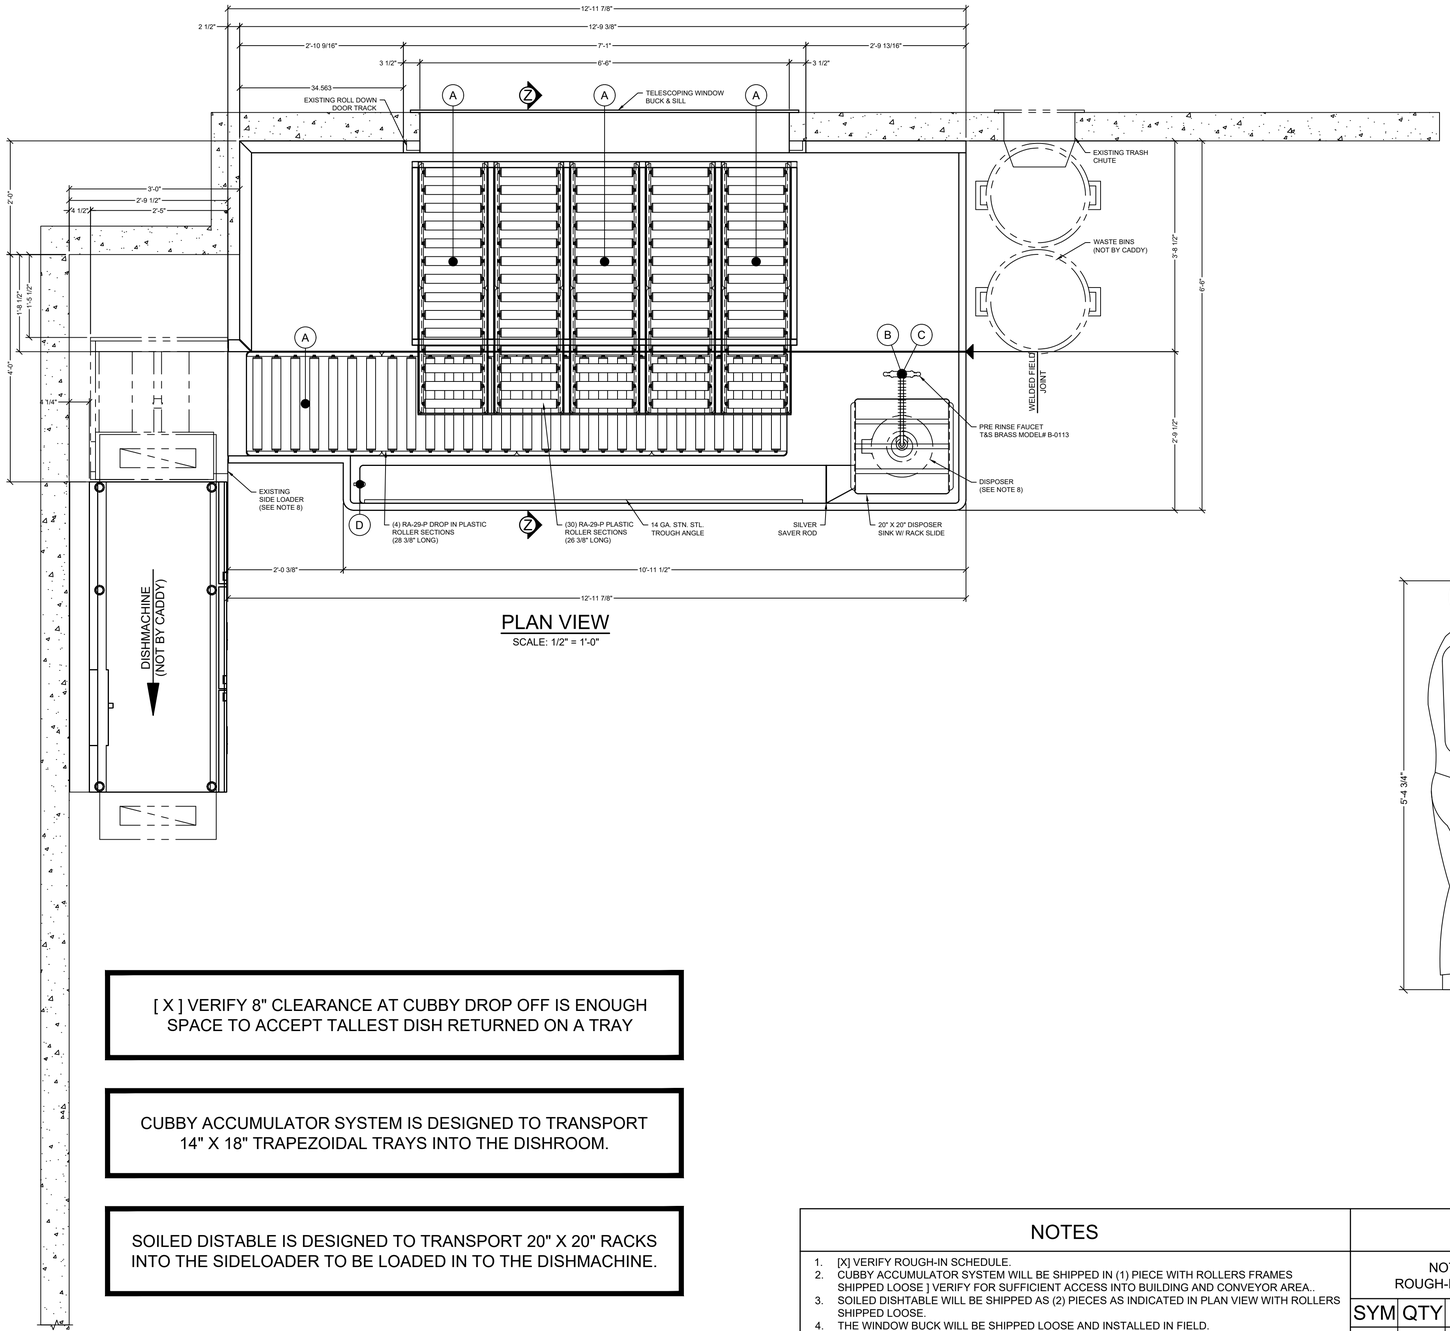

PLAN VIEW

SCALE: 1/2" = 1'-0"

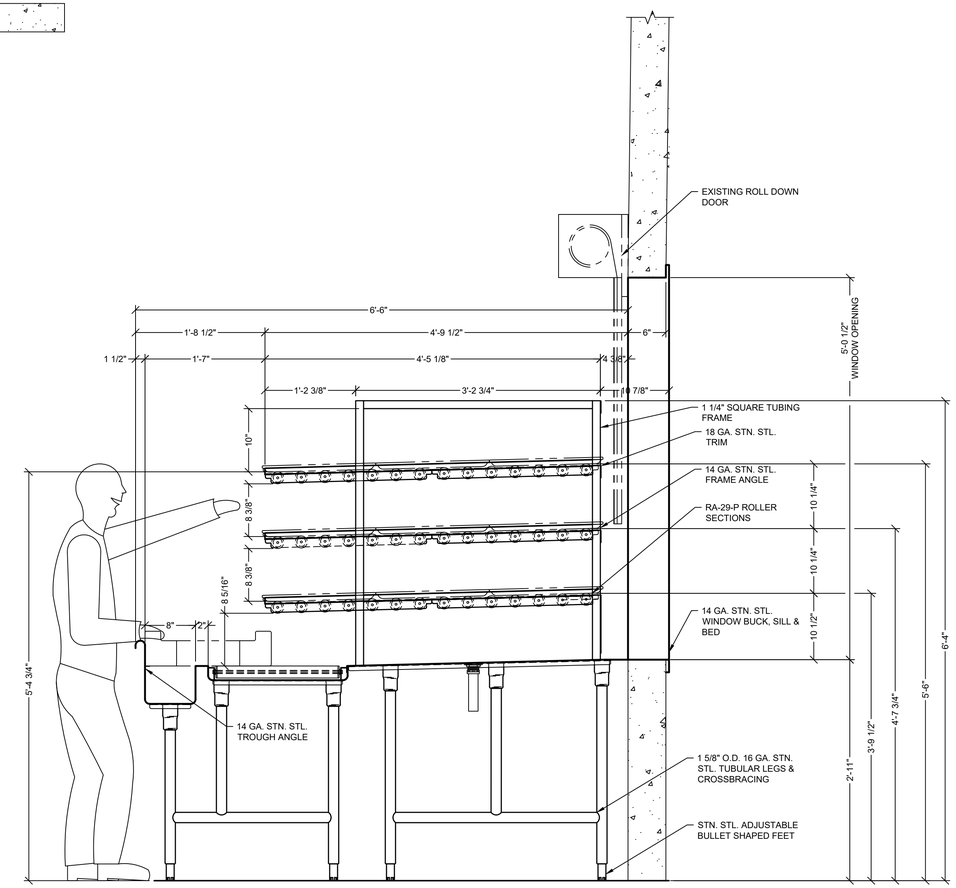

SECTION Z-Z

SCALE: 1" = 1'-0"

[X] VERIFY 8" CLEARANCE AT CUBBY DROP OFF IS ENOUGH SPACE TO ACCEPT TALLEST DISH RETURNED ON A TRAY

CUBBY ACCUMULATOR SYSTEM IS DESIGNED TO TRANSPORT 14" X 18" TRAPEZOIDAL TRAYS INTO THE DISHROOM.

SOILED DISTABLE IS DESIGNED TO TRANSPORT 20" X 20" RACKS INTO THE SIDELOADER TO BE LOADED IN TO THE DISHMACHINE.

NOTES

1. [X] VERIFY ROUGH-IN SCHEDULE.
2. CUBBY ACCUMULATOR SYSTEM WILL BE SHIPPED IN (1) PIECE WITH ROLLERS FRAMES SHIPPED LOOSE] VERIFY FOR SUFFICIENT ACCESS INTO BUILDING AND CONVEYOR AREA..
3. SOILED DISHTABLE WILL BE SHIPPED AS (2) PIECES AS INDICATED IN PLAN VIEW WITH ROLLERS SHIPPED LOOSE.
4. THE WINDOW BUCK WILL BE SHIPPED LOOSE AND INSTALLED IN FIELD.
5. THE CUBBY ACCUMULATOR IS DESIGNED TO RETURN 14" X 18" TRAPEZOIDAL TRAYS TO THE DISHROOM TO BE SCRAPPED.
6. THE SOILED DISHTABLE WITH ROLLER-VEYOR IS DESIGNED TO TRANSPORT 20" X 20" RACKS TO THE SIDELOADER AND THROUGH THE DISHWASHING MACHINE.
7. EXISTING SIDE LOADER IS HOBART MODEL# SL30
8. DISPOSER IS INSINKERATOR MODEL # SS-300-6-CC101

ROUGH-IN SCHEDULE

NOTE: STUB UP FLOOR ROUGH-INS 4" A.F.F.
ROUGH-INS EXTENDING FROM WALLS TO BE 10" A.F.F.

SYM	QTY	DESCRIPTION	
A	4	1 1/2" I.P.S. WASTE	
B	1	1/2" I.P.S. HOT WATER	
C	1	1/2" I.P.S. COLD WATER	
D	1	1/2" I.P.S. DIFFUSER	7/8" DIA. HOLE BY CADDY FISHER WATER INLET #2905

REVISIONS

REV	DATE	BY	REMARKS
A	12/21/23	JA	REDUCED DISHTABLE WIDTH BY 1" TO 6'-6" TO MATCH EXISTING SIDE LOADER.
B	01/31/24	JA	AS BUILT.

CADDY CORPORATION
509 SHARPTOWN ROAD, P.O. BOX 345
BRIDGEPORT, NJ 08014
TEL:(856) 467-4222 FAX:(856) 467-5511
WWW. CADDYCORP.COM

EQUIPMENT SCHEDULE

CUBBY ACCUMULATOR W/ SOILED DISHTABLE, WINDOW BUCK & SILL

CADDY NO. 37917-1,2,3 ITEM NO.1,2 & 3

JOB: DENSO - ATHENS
LOC:ATHENS, TN
CUST: PERFORMANCE FOODSERVICE
CUST #: KNX15085KA

DATE	12/08/23	SCALE	AS NOTED
DR BY	JA	APP'D BY	

DWG# 37917

SHT 1 OF 2

GENERAL CONTRACT CONDITIONS

ELECTRICAL WORK DONE BY CADDY CORPORATION IS EXECUTED IN COMPLIANCE WITH STANDARDS PUBLISHED BY THE UNDERWRITER'S LABORATORIES, INC. INSOFAR AS APPLICABLE, AND THE LATEST EDITION OF THE NATIONAL ELECTRICAL CODE (NEC). CADDY CORPORATION DOES NOT ACCEPT ANY RESPONSIBILITY FOR THE REQUIREMENTS OF ANY REGIONAL AND/OR LOCAL CODES THAT ADD OR DEVIATED FROM THE ACCEPTED STANDARDS OF THE ABOVE AGENCIES.

ANY FIELD WORK RELATING TO THE MODIFICATION OF ELECTRIC OR PLUMBING SYSTEMS, TO MEET REGIONAL OR LOCAL CODE REQUIREMENTS IS TO DONE BY OTHERS AND WITHOUT BACK CHARGES TO CADDY CORPORATION, UNLESS THESE CONDITIONS WERE PREVIOUSLY BROUGHT TO OUR ATTENTION AND ARE EXPRESSLY INCLUDED IN OUR WRITTEN QUOTATION.

ALL WIRING AND PLUMBING AT THE JOB SITE IS THE RESPONSIBILITY OF OTHERS. EQUIPMENT WILL BE CONSTRUCTED IN ACCORDANCE WITH OUR DRAWING(S) WHICH MUST BE APPROVED PRIOR TO FABRICATION. ANY SUBSEQUENT CHANGES REQUIRED MUST BE SUBMITTED TO US IN WRITING AND ACKNOWLEDGED ON OUR STANDARD FORM.

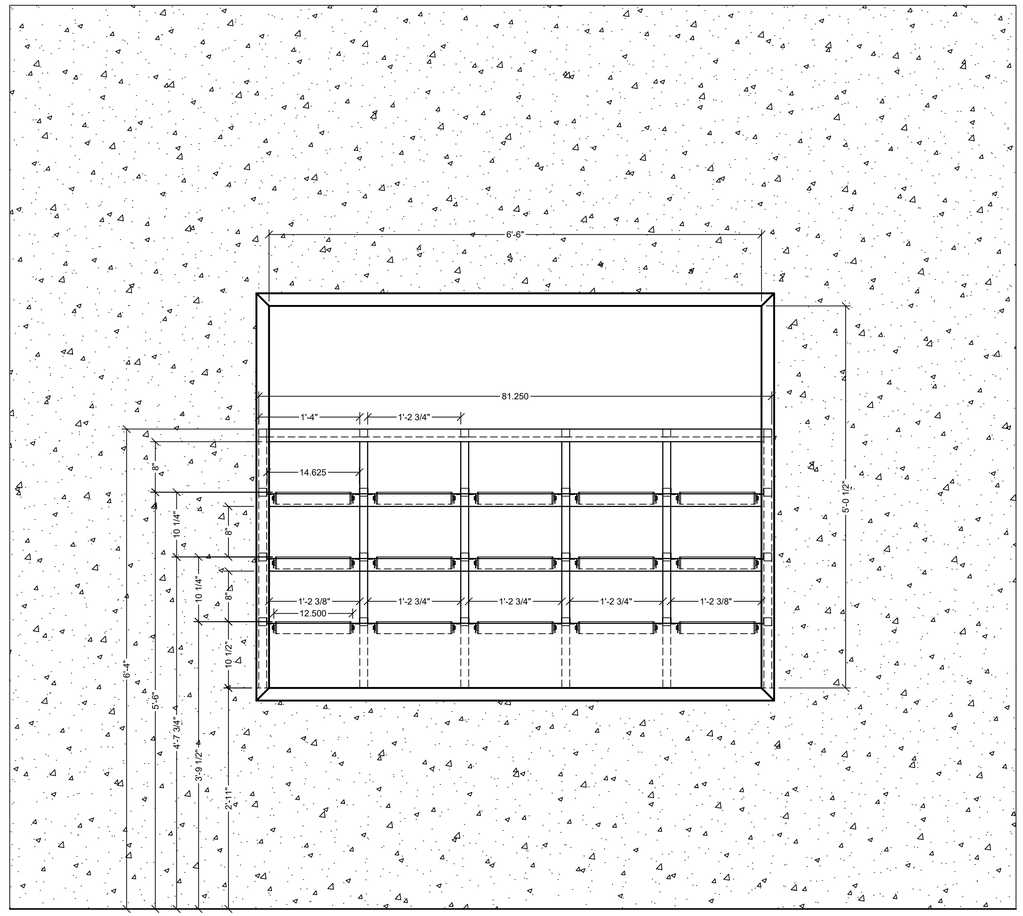

CAFETERIA ELEVATION

SCALE: 1" = 1'-0"

[ ] VERIFY 8" CLERANCE AT CUBBY DROP OFF IS ENOUGH SPACE TO ACCEPT TALLEST DISH RETURNED ON A TRAY

NSF

ROUGH-IN SCHEDULE

NOTE: STUB UP FLOOR ROUGH-INS 4" A.F.F.
ROUGH-INS EXTENDING FROM WALLS TO BE 10" A.F.F.

SYM	QTY	DESCRIPTION	
A	4	1 1/2" I.P.S. WASTE	
B	1	1 1/2" I.P.S. DIFFUSER	2" DIA. HOLE BY CADDY DIFFUSER BY OTHERS

REVISIONS

REV	DATE	BY	REMARKS
A	12/21/23	JA	NO CHANGES TO THIS SHEET.
B	01/31/24	JA	AS BUILT.

CADDY CORPORATION
509 SHARPTOWN ROAD, P.O. BOX 345
BRIDGEPORT, NJ 08014
TEL:(856) 467-4222 FAX:(856) 467-5511
WWW. CADDYCORP.COM

EQUIPMENT SCHEDULE

CUBBY ACCUMULATOR W/ SOILED DISHTABLE, WINDOW BUCK & SILL

CADDY NO. 37917-1,2,3 ITEM NO.1,2 & 3

JOB: DENSO - ATHENS
LOC:ATHENS, TN
CUST: PERFORMANCE FOODSERVICE
CUST #: KNX15085KA

DATE	10/16/23	SCALE	AS NOTED
DR BY	JA	APP'D BY	JA

DWG# 37917

SHT 2 OF 2

GENERAL CONTRACT CONDITIONS

ELECTRICAL WORK DONE BY CADDY CORPORATION IS EXECUTED IN COMPLIANCE WITH STANDARDS PUBLISHED BY THE UNDERWRITER'S LABORATORIES, INC. INSOFAR AS APPLICABLE, AND THE LATEST EDITION OF THE NATIONAL ELECTRICAL CODE (NEC). CADDY CORPORATION DOES NOT ACCEPT ANY RESPONSIBILITY FOR THE REQUIREMENTS OF ANY REGIONAL AND/OR LOCAL CODES THAT ADD OR DEVIATED FROM THE ACCEPTED STANDARDS OF THE ABOVE AGENCIES.

ANY FIELD WORK RELATING TO THE MODIFICATION OF ELECTRIC OR PLUMBING SYSTEMS, TO MEET REGIONAL OR LOCAL CODE REQUIREMENTS IS TO DONE BY OTHERS AND WITHOUT BACK CHARGES TO CADDY CORPORATION, UNLESS THESE CONDITIONS WERE PREVIOUSLY BROUGHT TO OUR ATTENTION AND ARE EXPRESSLY INCLUDED IN OUR WRITTEN QUOTATION.

ALL WIRING AND PLUMBING AT THE JOB SITE IS THE RESPONSIBILITY OF OTHERS. EQUIPMENT WILL BE CONSTRUCTED IN ACCORDANCE WITH OUR DRAWING(S) WHICH MUST BE APPROVED PRIOR TO FABRICATION. ANY SUBSEQUENT CHANGES REQUIRED MUST BE SUBMITTED TO US IN WRITING AND ACKNOWLEDGED ON OUR STANDARD FORM.